

Proposed GNPA settlement boundary shown as solid red line


H2
Include area for completeness

Site A

Site at which the standard of retention was raised 1715

Document MAR 1.5

Enabled by OS Outdoors
© Crown Copyright 2009. All rights reserved. Licence number: 100020449. Pictorial Scale: 1:6893

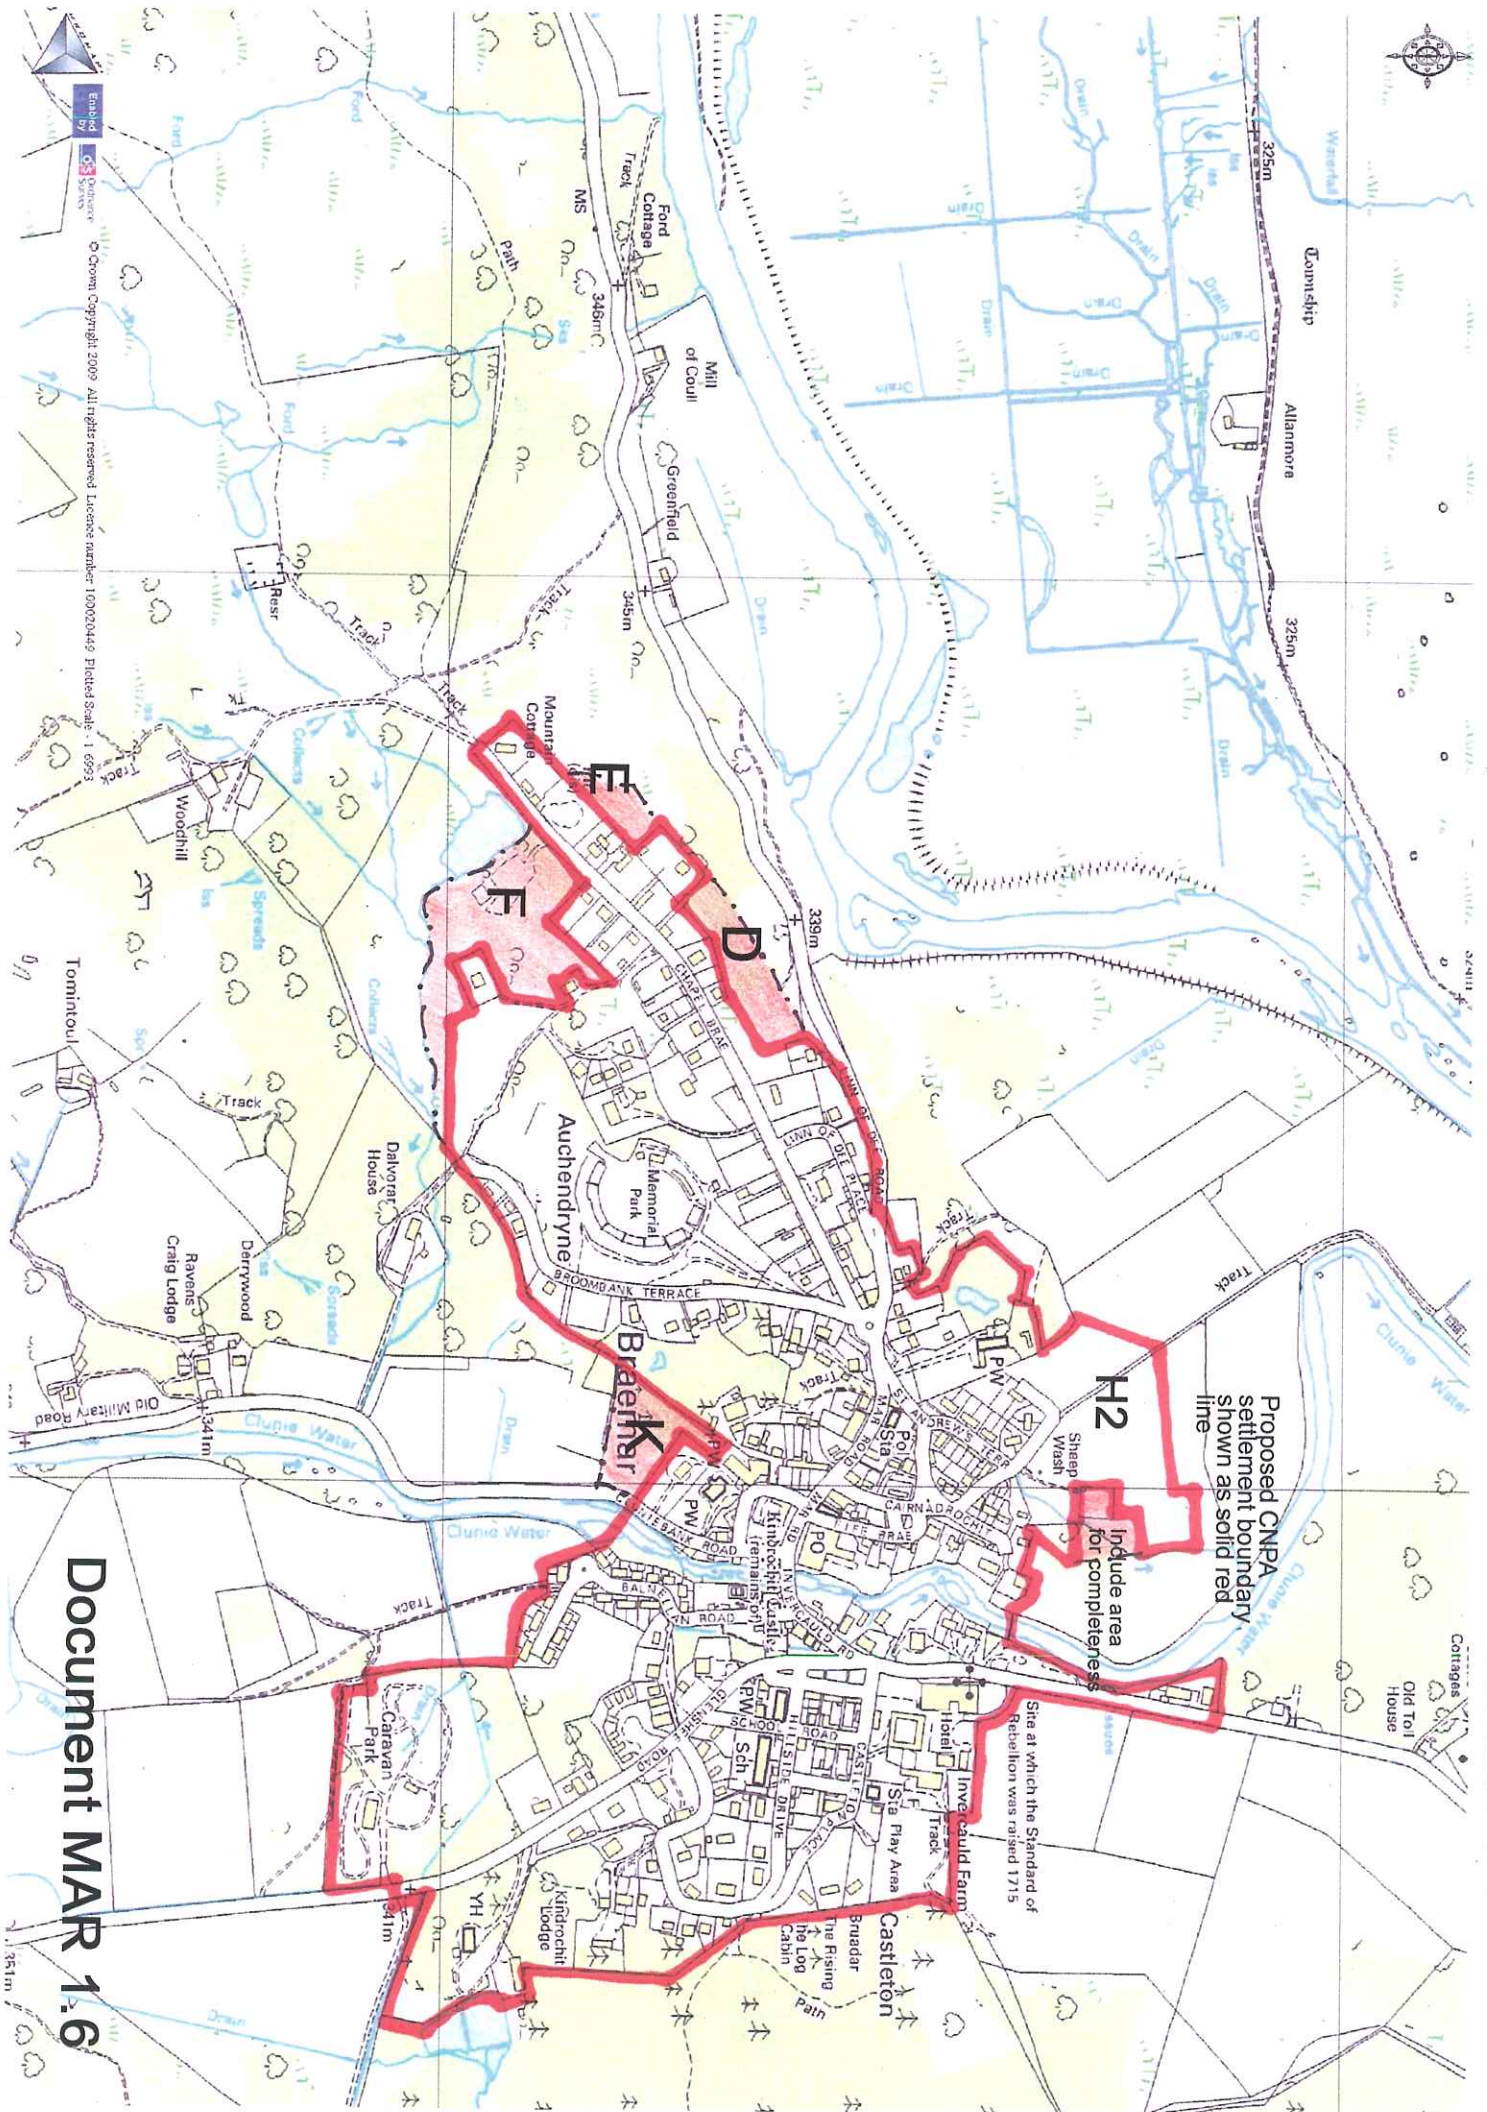

Proposed CNPA settlement boundary shown as solid red line

H2
Include area for completeness

Site at which the Standard of Rebellion was raised 1715

Document MAR 1.6

Enabled by OS OpenView
© Crown Copyright 2009. All rights reserved. Licence number: 100020449. Projected Scale: 1:6693