



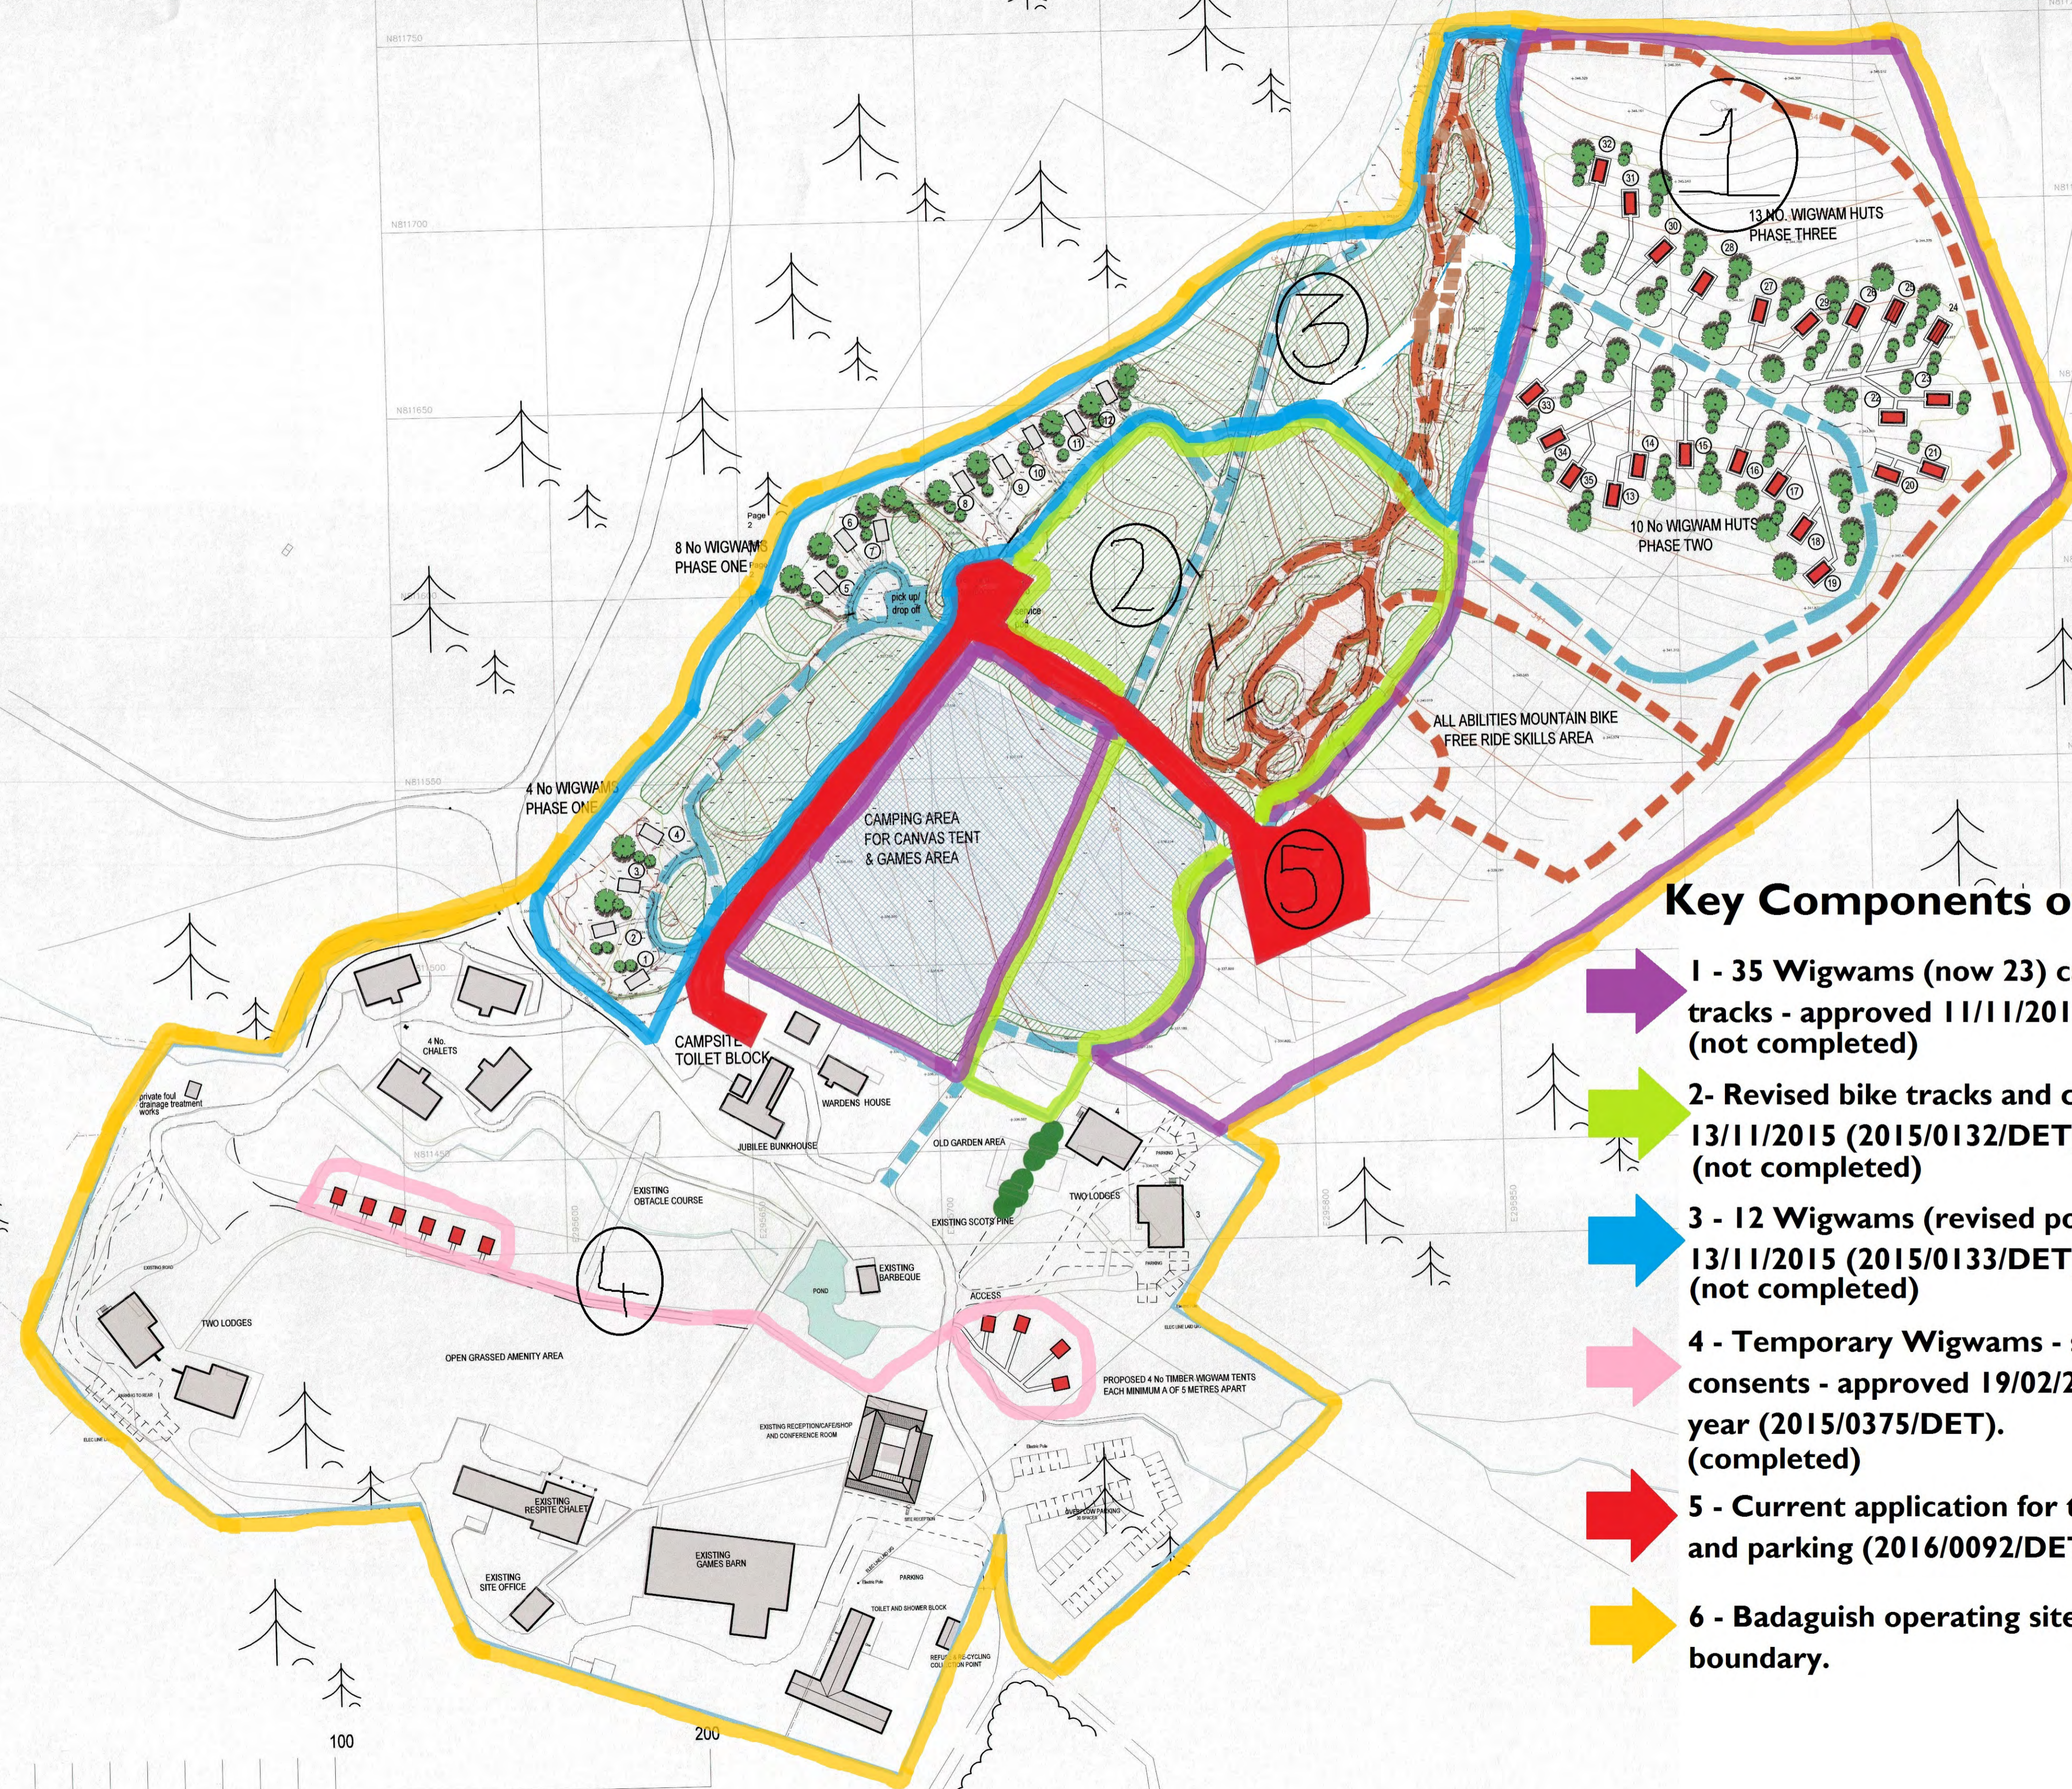




AGENDA ITEM 5

APPENDIX 4

MASTERPLAN

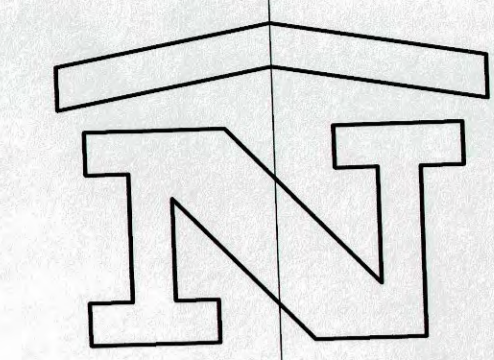


Key Components of "Masterplan"

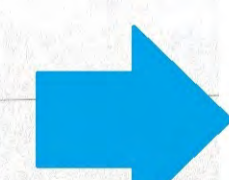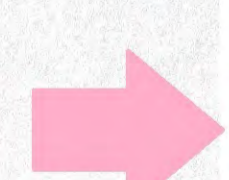-  **1 - 35 Wigwams (now 23) camp site and bike tracks - approved 11/11/2011 (2011/0206/DET) (not completed)**
-  **2- Revised bike tracks and camp site - approved 13/11/2015 (2015/0132/DET) (not completed)**
-  **3 - 12 Wigwams (revised position) - approved 13/11/2015 (2015/0133/DET). (not completed)**
-  **4 - Temporary Wigwams - series of temporary consents - approved 19/02/2016 for 1 further year (2015/0375/DET). (completed)**
-  **5 - Current application for toilet/kitchen pod and parking (2016/0092/DET).**
-  **6 - Badaguish operating site boundary.**

- Key to Colours**
-  Grassed Area with Edges Landscaped
 -  Landscaping as per Tree Planting Plan
 -  Wheelchair Access Pathways
 -  Mountain Bike Trail
 -  Canvas Tenting & Games Area
 -  Development Area Boundary
 -  Wigwam position

Area outwith red line, outlined in blue is extent of site ownership. Works consented under previous consents or other current applications.

SCALE OF METRES

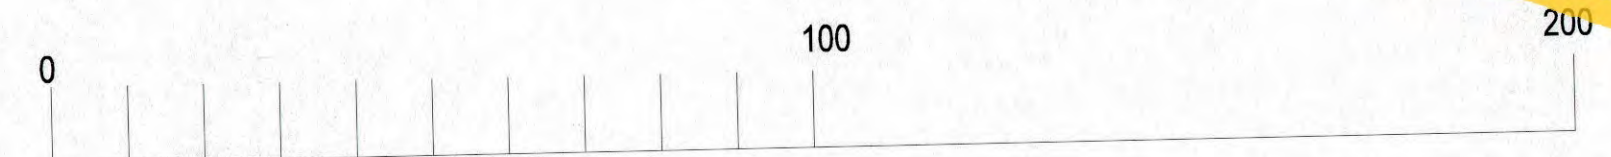

REVISIONS

Bracewell Stirling CONSULTING

5 NESS BANK, INVERNESS, IV2 4SF
TEL: 01463 233760 FAX: 01463 233785

38 WALKER TERRACE, TILLCOUNTRY, FK13 6EF
TEL: 01259 750301 FAX: 01259 752365

KITCHEN AND TOILET POD
BADAGUISH OUTDOOR CENTRE
SPEYSIDE TRUST

SITE LAYOUT

SCALE	1:2500	DATE	JAN 16	BY	AMacR
			PLANNING		
DWG NO	4124 / 02-050			REV	